

**From:** [BDC Lgoima](#)  
**To:** [REDACTED]  
**Subject:** Official Information Request for Buller Bridge Information Ref: OIA 107/23  
**Date:** Tuesday, 14 November 2023 8:14:00 am  
**Attachments:** [REEFTON SUSPENSION BRIDGE Buller District Council - Parks and Reserves 25-10-2023.pdf](#)  
[Fox River Bridge Buller District Council - Parks and Reserves 25-10-2023.pdf](#)  
[MOKIHINUI PEDESTRIAN BRIDGE Buller District Council - Parks and Reserves 25-10-2023.pdf](#)  
[HAMPTONS ROCK Buller District Council - Parks and Reserves 25-10-2023.pdf](#)  
[BLACKS POINT SUSPENSION BRIDGE Buller District Council - Parks and Reserves 25-10-2023.pdf](#)  
[BDC - TOKI POUTANGATA BRIDGE.pdf](#)  
[image006.png](#)

Dear [REDACTED]

We refer to your official information request dated 18 October 2023 for information regarding bridges in Buller. You asked for the below information:

*Objective:*

*We're trying to establish the total bridge market size in the region.*

*We are interested in cycle, pedestrian and service bridges. If it helps, we are not interested in main road, two way car bridges.*

*To do this we require the below information please. It would be super helpful if it was in a csv or spreadsheet format to help us filter. Thanks again!*

*The data we are looking for:*

*material bridge made out of*

*value of asset*

*cost of build*

*cost of replacement*

*Year of build*

*design life*

*Expected rebuild/replacement date*

*Size*

*Who built the bridge (i.e the civil contractor) and or if different*

*Who supplied the bridge (won the contract).*

*cost of replacement (broken down by earthworks vs structure cost if known)*

*Can we get this broken down by*

*Service bridge vs non service (i.e service, pedestrian, cycle, etc..)*

*Bridge type (boardwalk, clip on, suspension bridge plus any other types you have)*

*Importantly, if available any forecasting data you have on bridge building for the next 5 years. What bridges are you expecting to a) build or rebuild, and b) upgrade/repair*

The information you have requested is attached and below:

*BDC has following 6 Pedestrian/foot bridges on BDC asset register as noted in following table.*

| Road controlling authority (RCA)               | Location              | Type       | Bridge ID | Bridge name                    | Status  |
|--|-----------------------|------------|-----------|--------------------------------|---|
| <b>Buller District Council</b>                 | Auld Street           | Footbridge | 1001      | BLACKS POINT SUSPENSION BRIDGE | Maintained by BDC   |
| <b>Buller District Council</b>                 | BEACH RD (Charleston) | Footbridge | 169       | HAMPTONS ROCK                  | currently closed due to storm damage Feb 22                                 |
| <b>Buller District Council</b>                 | MOKIHINUI ROAD        | Footbridge | 177       | MOKIHINUI PEDESTRIAN BRIDGE    | This Bridge has been Removed when Burkes Ford was washed out in 2022 flood  |
| <b>Friends of the fox river bridge society</b> | SH6                   | Footbridge | 170       | FOX RIVER BRIDGE               | Currently closed and Transferred to friends of the fox river bridge society |
| <b>Buller District Council</b>                 | SH6                   | Footbridge | 1000      | REEFTON SUSPENSION BRIDGE      | Pedestrian/other trust interests/<br>Pedestrian                             |

| <b>Buller District Council</b> | <i>Adderley street</i> | <i>Footbridge</i> | <i>TBC</i> | TOKI POUTANGATA BRIDGE | <i>bridge</i> |
|--------------------------------|------------------------|-------------------|------------|------------------------|---------------|
|                                |                        |                   |            | Total 6 structures     |               |

To provide all the requested information, I have attached a separate pdf for each bridge listed in table above.

Some of the requested information is not available in the BDC system as most of the bridges are constructed approx. 40-50 years back.

Kawatiri coastal trail Trust (KCT) have recently built a number of foot/cycle bridges in Westport, these bridges are privately owned and maintained by the KCT trust.

If you could contact KCT trust office, you will get most up to date construction data.

<https://kawatiricoastaltrail.co.nz/contact/>

You have the right to seek an investigation and review by the Ombudsman of this decision. Information about how to make a complaint is available at [www.ombudsman.parliament.nz](http://www.ombudsman.parliament.nz) or freephone 0800 802 602.

If you wish to discuss this decision with us, please feel free to contact the Buller District Council by return email to [lgoima@bdc.govt.nz](mailto:lgoima@bdc.govt.nz).

Please note that it is our policy to proactively release our responses to official information requests where possible. Our response to your request will be published shortly at <https://bullerdc.govt.nz/district-council/your-council/request-for-official-information/responses-to-lgoima-requests/> with your personal information removed.

Kind regards

Michael Duff | Group Manager Infrastructure Services  
DDI 037889646 | Mobile 027 543 9604 | Email [Michael.Duff@bdc.govt.nz](mailto:Michael.Duff@bdc.govt.nz)

Buller District Council | Phone 0800 807 239 | [bullerdc.govt.nz](http://bullerdc.govt.nz)  
PO Box 21 | Westport 7866

Community Driven | One Team | Future Focused | Integrity | We Care

Email Disclaimer: This correspondence is for the named person's use only. It may contain confidential or legally privileged information or both. No confidentiality or privilege is waived or lost by any mistransmission. If you receive this correspondence in error, please immediately delete it from your system and notify the sender. You must not disclose, copy or relay any part of this correspondence if you are not the intended recipient. Any views expressed in this message are those of the individual sender, except where the sender expressly, and with authority, states them to be the views of Buller District Council.



# TOKI POUTANGATA BRIDGE

## THE RIVERBANK PROJECT

WESTPORT WATERFRONT REVITALISATION





TOKI POUTANGATA BRIDGE FACT FILE:

- Designed by DC Structures Studio
- Tapering truss max. height 5.8m
- Total overall width 3.1m
- Total overall length 38m
- Span between bearings 29m
- Full lift weight 24 tonnes
- Deck height 5.4m above ground
- Ramp linear walk length 77m
- Grade 1:12, rest zones every 9m
- Walkway width 2.5m & 2.3m
- FRP non-slip decking 28mm thick






# INSIGHT FOR OTHER LOCAL AUTHORITIES

The true insight and reward for local authorities to gain from this project is the opportunity and benefit from working closely with iwi. Toki Poutangata shows how the simple idea of a functional asset, such as a bridge, when approached with openness, trust and mutual respect can evolve relationships through shared values and visions, which ultimately deliver far more utility and meaning than ever envisaged. What could have been a simple technical structure has been transformed into an iconic, symbolic landmark that now represents the bridging of friendship, partnership and togetherness, and highlights what is most important between Council, Ngāti Waewae and our communities.

He tangata, he tangata, he tangata. It is the people, it is the people, it is the people.



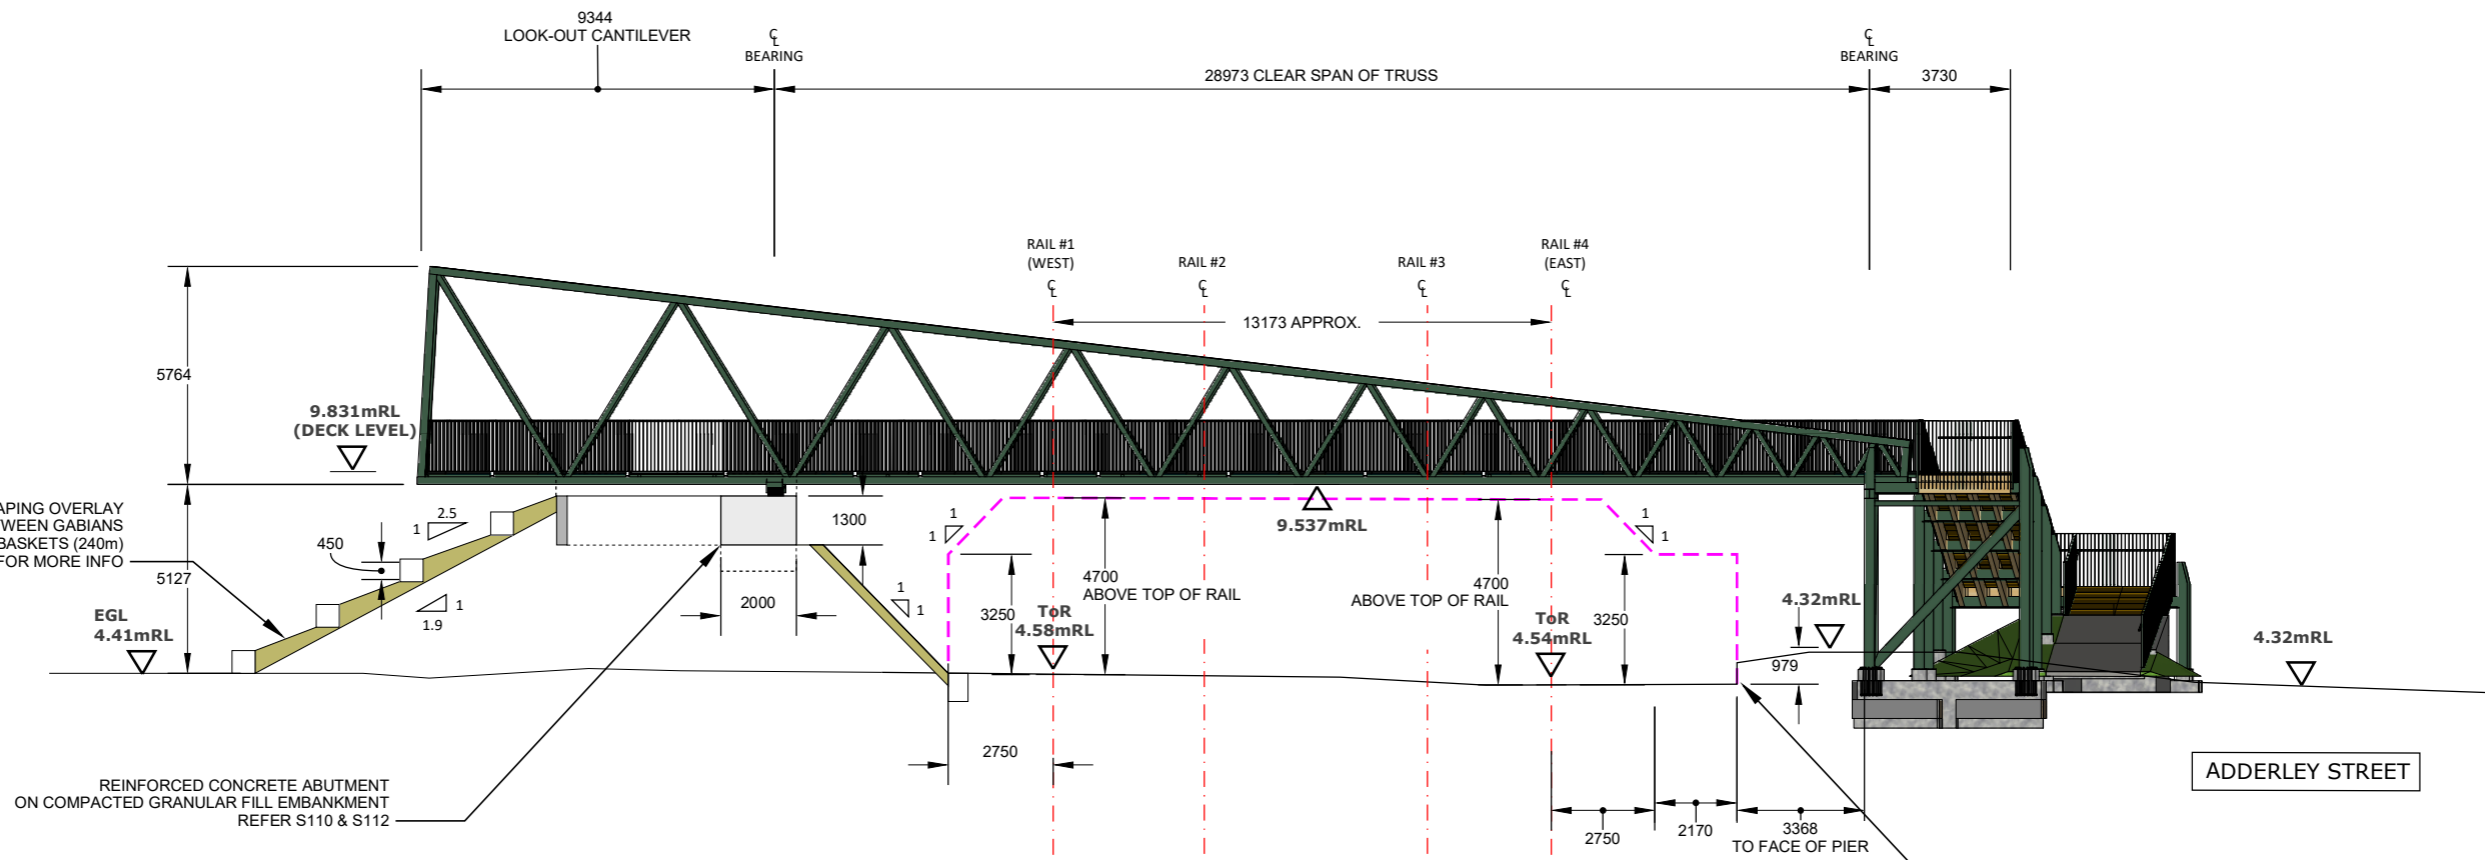

**BRIDGE ELEVATION (FROM SOUTH LOOKING NORTH)**

BE S100 1:200 @ A3

**NOTES (APPLICABLE TO ALL DRAWINGS):**

**1 - GENERAL NOTES:**

- ALL DIMENSIONS ARE IN MILLIMETERS UNLESS NOTED OTHERWISE.
- THIS DRAWING IS TO BE READ IN CONJUNCTION WITH ALL DRAWINGS LISTED ON THE COVER SHEET.
- COORDINATES IN TERMS OF NZTM 2000. LEVELS IN TERMS OF LYTELTON VERTICAL DATUM 1937.

**2 - DESIGN LOADING:**

LOADINGS SUMMARISED BELOW:

**VERTICAL LOADING:**

| LOAD TYPE | LOAD                   | SLS FACTOR | ULS FACTOR |
|-----------|------------------------|------------|------------|
| STEEL WT. | 77 kN/m <sup>3</sup>   | 1.0        | 1.35       |
| DECK WT.  | 0.15 kN/m <sup>2</sup> | 1.0        | 1.35       |
| LIVE LOAD | 5 kPa                  | 1.0        | 1.76       |

**BARRIER LOADING:**

LOADINGS ARE BASED ON NZTABM APPENDIX B SUMMARISED BELOW.:

| LOAD TYPE | LOAD      | SLS | ULS |
|-----------|-----------|-----|-----|
| TOP RAIL  | 1.75 KN/M | 1.0 | 1.8 |
| INFILL    | 1.5 KPA   | 1.0 | 1.8 |

**SEISMIC CRITERIA:**

CRITERIA AS PER AS/NZS1170.5:

|                     |                      |
|---------------------|----------------------|
| IMPORTANCE FACTOR   | 2                    |
| DESIGN LIFE         | 100 YEARS            |
| ULS RETURN PERIOD   | 500 YEARS (Ru = 1.0) |
| ZONE FACTOR         | 0.30                 |
| SOIL CLASS          | D                    |
| PERIOD OF VIBRATION | <0.5 SECS            |
| DUCTILITY           | μ = 1.00             |

**RAILWAY IMPACT:**

500KN IMPACT LOAD APPLIED AT BOTTOM CHORD CENTRE AT EACH RAILWAY CENTRE LINE FROM NORTH OR SOUTH DIRECTION (ONLY ONE IMPACT PER CASE).

APPLIED AS PER NZTABM COMBINATION ULS3C.

**WIND LOADING:**

THE DESIGN GUST WIND SPEEDS ACTING ON THE BRIDGE ARE DERIVED FROM SECTION 3.4.5 OF THE NZTA BRIDGE MANUAL, AS / NZS 1170.2 AND BD37/01.

NZS1170.2 SLS (1/25) AND ULS (1/500) WIND SPEEDS = 28.0 AND 34m/s RESPECTIVELY.

WHEN CONSIDERING WIND + LIVE LOAD EFFECTS (AND ALLOWING FOR 1.25m SOLID HEIGHT ABOVE DECK) THE WIND SPEED IS LIMITED TO 22m/s (80 Km/hr) FOR ULS AND SLS EVENTS.

**3 - MAINTENANCE AND INSPECTION:**

- BRIDGE INSPECTION AND REPORTING SHALL BE IN ACCORDANCE WITH THE NZTA BRIDGE INSPECTION POLICY TNZ S6-2000 WHICH REFERENCES THE DEPARTMENT OF TRANSPORT (UK) BRIDGE INSPECTION GUIDE, (DOT, 1983).
- AS PER TNZ S6-2000 A "GENERAL INSPECTION" SHALL BE CARRIED OUT EVERY 2 YEARS AND A "DETAILED INSPECTION" EVERY 6 YEARS.
- THE DETAILED INSPECTION SHALL BE PERFORMED BY A SUITABLY QUALIFIED BRIDGE INSPECTOR OR BRIDGE ENGINEER (AS PER TNZ S6-2000). IT IS RECOMMENDED THAT THE DETAILED INSPECTION (EVERY 6 YEARS) IS CARRIED OUT BY A BRIDGE ENGINEER WITH FAMILIARITY WORKING WITH STEEL AND TIMBER STRUCTURES.
- THE INSPECTIONS SHALL RECORD ANY REQUIRED MAINTENANCE/REPLACEMENT ACTIVITIES AND THEN BE FORWARDED TO THE MAINTENANCE TEAMS FOR COMPLETION WITHIN A PRE-SET TIMEFRAME.
- TO IMPROVE AWARENESS OF DESIGN LIVES, SPECIFICATIONS, AND GENERAL DETAILS OF REPLACEABLE ITEMS, PLEASE REFER TO THE MAINTENANCE SCHEDULE OPPOSITE. THE INTENTION OF THIS TABLE IS TO IDENTIFY KEY INSPECTION ITEMS.
- THE MAINTENANCE TABLE ALSO ENABLES INSPECTION TEAMS TO APPRECIATE "WHEN" THE DESIGNERS ARE ANTICIPATING THAT STEELWORK IS TO BE RECOATED, TIMBER REPLACED, FRP REPLACED, ETC. THIS SHOULD PREVENT THE INSPECTOR NEEDING TO AIR ON THE SIDE OF CAUTION (WHEN SUCH INFORMATION IS NOT OTHERWISE PRESENTED).
- IT IS STRONGLY RECOMMENDED THAT THE "POUTANGATA BRIDGE DESIGN STATEMENT" SHALL BE READ PRIOR TO ANY SIGNIFICANT CHANGES BEING MADE TO THE BRIDGE (E.G. ADDITIONAL SERVICES BEING ADDED, CHANGE OF BALUSTRADES, ETC.).
- KIWRAIL WILL ALSO BE CARRYING OUT ANNUAL GENERAL INSPECTIONS AS PER THE KIWRAIL INSPECTION STANDARD AS REQUIRED FOR ALL 3RD PARTY BRIDGE ACCROSS RAILWAY CORRIDOR. IT IS ENVISAGED THAT BDC MIGHT WANT TO COORDINATE THIS WITH KIWRAIL TO PREVENT UNECESSARY DOUBLING UP OF GENERAL INSPECTIONS.

**AS-BUILT MEASURED CLEARANCES OVER RAILWAY**

SURVEY DONE 10 FEB 2022  
TAKEN UNDERSIDE OF BOTTOM CHORD TO TOP OF RAIL:

RAIL #1 = 4870mm NORTH // 4890mm SOUTH  
RAIL #2 = 4960mm NORTH // 4960mm SOUTH  
RAIL #3 = 5000mm NORTH // 4980mm SOUTH  
RAIL #4 = 5080mm NORTH // 5060mm SOUTH

| INSPECTION/MAINTENANCE ACTIVITY                      | REPLACEMENT   | REFERENCE    |
|--|---------------|--------------|
| RE-APPLY / CLEAN ANTI-GRAFFITI                       | AS REQUIRED   | NOTE 6. S112 |
| CONCRETE COATINGS                                    |               |              |
| RE-APPLY / CLEAN GLULAM BEAM                         | AS REQUIRED   | S140         |
| COATINGS   | FOR COSMETICS |              |
| REPAIR / RE-APPLY STEELWORK ANTI-CORROSION SYSTEM    | ≤ 40 YEARS    | S120         |
| INSPECT AND/OR REPLACE FRP DECKING                   | ≤ 50 YEARS    | S102         |
| REPLACE GLULAM TIMBER BEAMS                          | ≤ 50 YEARS    | S140         |
| JACK BRIDGE AND REPLACE WESTERN ELASTOMERIC BEARINGS | ≤ 50 YEARS    | S112 & S116  |


**BRIDGE MAINTENANCE SCHEDULE**

|    |   |
|----|---|
| MS | - |
|----|---|

| REV | DESCRIPTION        | DATE    | DESIGN | DRAWN | APPROVED |
|-----|--------------------|---------|--------|-------|----------|
| A   | CONCEPT DESIGN     | JULY 20 | DC     | PS    | DC       |
| B   | PRELIM DESIGN      | SEP 20  | DC     | PS    | DC       |
| C   | 85% KIWRAIL REVIEW | NOV 20  | DC     | PS    | DC       |
| D   | FOR FINAL REVIEW   | FEB 21  | DC     | PS    | DC       |
| E   | FOR CONSTRUCTION   | APR 21  | DC     | PS    | DC       |
| F   | AS BUILT           | FEB 22  | DC     | PS    | DC       |


DO NOT SCALE. IF IN DOUBT ASK



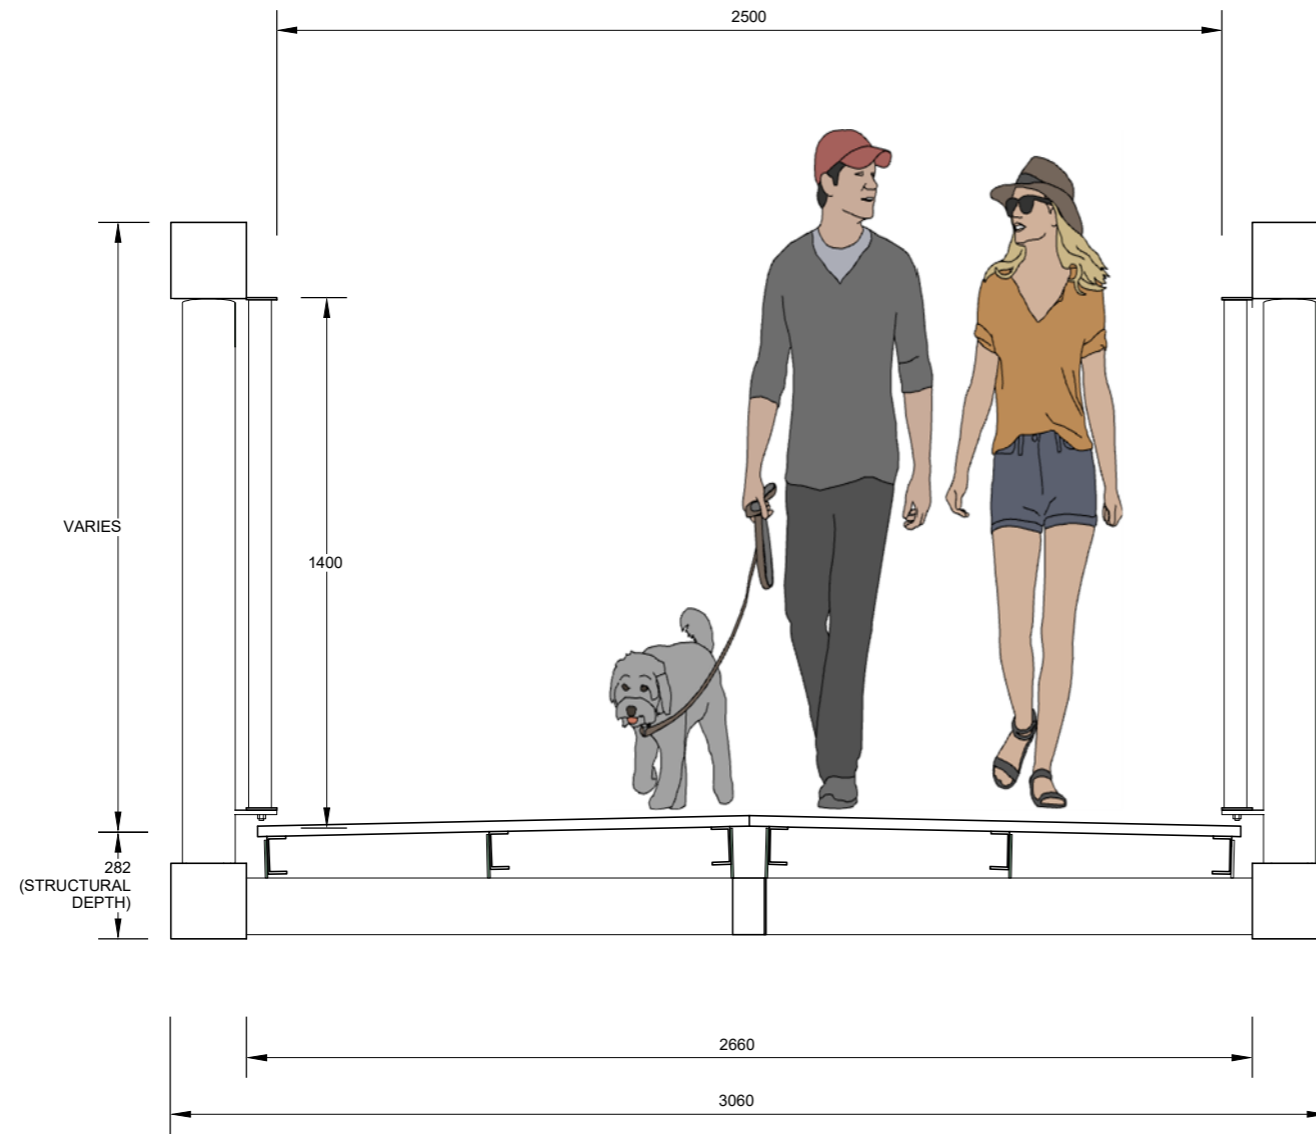

**STEEL TRUSS WALKWAY CROSS SECTION**

|    |      |           |
|----|------|-----------|
| TX | BR03 | 1:20 @ A3 |
|    | BR04 |           |
|    | BR05 |           |

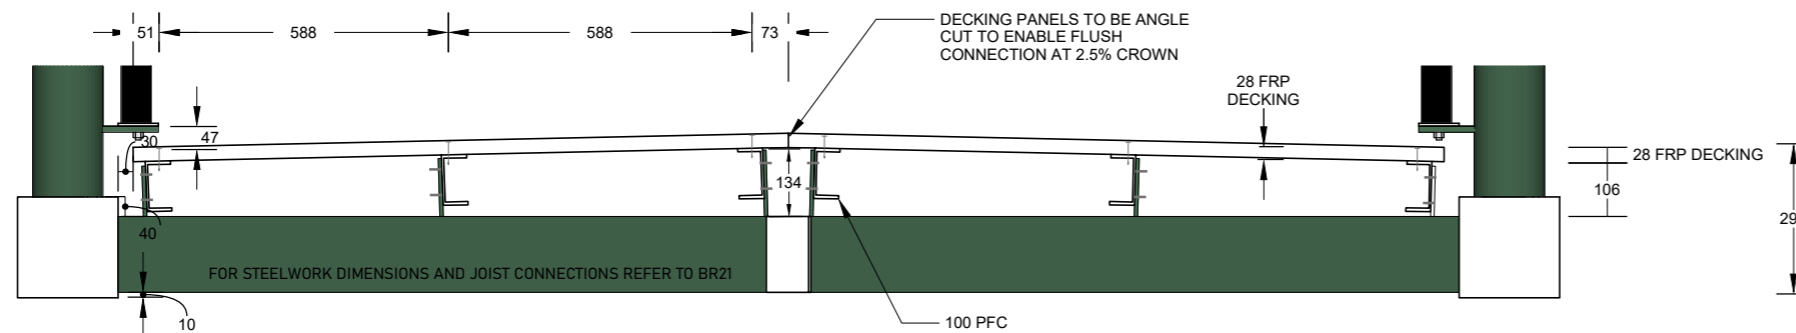

**STEEL JOISTS AND DECKING DETAIL**


|    |   |           |
|----|---|-----------|
| DX | - | 1:15 @ A3 |
|----|---|-----------|

**NOTES:**

- REFER TO DRAWINGS S120 TO S123 FOR ALL SUPERSTRUCTURE STEELWORK.
- REFER TO DRAWING S140 FOR ALL TIMBER NOTES.

**FRP DECKING AND FIXINGS:**

- FIBRE REINFORCED POLYMER (FRP) DECKING TO BE POLYESTER RESIN (O-SEIRES) OR ISOTHALIC RESIN (I-SERIES) PROVIDED BY "TREADWELL NZ" (OR ALTERNATIVE AS APPROVED BY ENGINEER) SUPPLIED WITH A MINIMUM 10 YEAR WARRANTY.
- PANELS ARE TO BE 25mm THICK 38x38 FRP GRID WITH A 3mm SOLID PANEL TOPPING (28mm TOTAL DEPTH).
- PANEL COLOURS TO BE:  
TRUSS = "FERN GREEN" (RAL 6025)  
RAMPS = "OLIVE BROWN" (RAL 8008)
- INDEPENDENT LABORATORY TESTING IS TO BE PERFORMED, AND CERTIFIED BY A CPEng ENGINEER OR RECOGNISED TESTING LAB, TO CONFIRM:
  - ULS STRENGTH USING A LOAD FACTOR OF 1.76 FOR: 5KPa LIVE LOAD APPLIED OVER THE WHOLE PANEL;
  - 5KPa DEFLECTIONS < SPAN/200 = 3mm;
  - WET PENDULUM (SLIP RESISTANCE) TESTING AS/NZS 4586 2004 SRV >39
  - ≥ 50 YEARS DURABILITY / UV EXPOSURE
- FIXINGS FOR ATTACHING FRP TO THE STEEL JOISTS WILL BE SS316 M8 BOLT TAPPED INTO PFC (E.G. ANZOR "BUTTON HEAD SOCKET SCREWS" SSHBM) IN COMBINATION WITH SS316 D-CUP WITH 9mm ORIFICE. USE SIKALASTOMER 511 (BUTYL RUBBER ISOLATING SYSTEM) GREASE ON BOLT SHANK AND BACK OF HOLE TO MAINTAIN CORROSION PROTECTION. JOIST TO BE FABRICATED AND PAINTED WITHOUT HOLES. FRP PANEL TO BE FITTED OVER COMPLETED TRUSS. HOLES TO BE DRILLED AND TAPPED FOR AN M8 BOLT. FRP PANEL TO BE REMOVED AND HOLE TO BE CLEANED UP (ALL DRILL DUST AND BURRS TO BE REMOVED ETC.). TOUCH UP ANY MAJOR PAINT DEFECTS AS REQUIRED. RE-ALIGN FRP PANELS AND FIX DOWN. FIXINGS ARE REQUIRED ALONG EACH JOIST. REFER TF/S122 FOR FIXING PATTERN.
- FIXINGS FOR ATTACHING THE FRP PANELS TO THE GLULAM BEAMS WILL BE A 14g (M6.3) X 150mm SS316 SELF-TAPPING HEX WASHER HEAD 14g (M6.3) (ANZOR #SSTHG14-150T17). HOLES TO BE PREDRILLED. FIXINGS ALONG EACH BEAM TO
- FIXINGS WILL BE COUNTERSUNK INTO THE FRP DECK PANELS USING A 44DIA SS316 "D-CUP" WASHER WITH 9mm ORIFICE (REFER FIGURE BELOW).

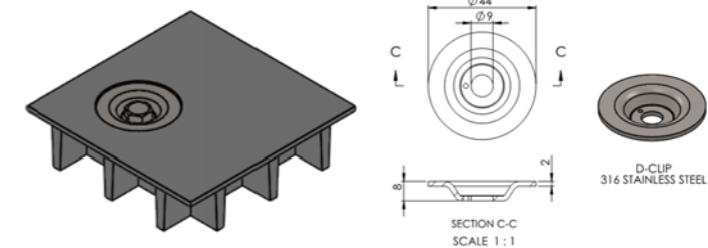

| REV | DESCRIPTION         | DATE   | DESIGN | DRAWN | APPROVED |
|-----|---------------------|--------|--------|-------|----------|
| A   | NOT USED            |        |        |       |          |
| B   | PRELIM DESIGN       | SEP 20 | DC     | PS    | DC       |
| C   | 85% KIWIRAIL REVIEW | NOV 20 | DC     | PS    | DC       |
| D   | FOR FINAL REVIEW    | FEB 21 | DC     | PS    | DC       |
| E   | FOR CONSTRUCTION    | APR 21 | DC     | PS    | DC       |
| F   | AS BUILT            | FEB 22 | DC     | PS    | DC       |

**Footbridge 1001 BLACKS POINT SUSPENSION BRIDGE**
**Location Details**

|                          |                 |
|--------------------------|-----------------|
| RAMM / Alt. Database ID: |                 |
| Road Name:               | Auld Street     |
| Waterway Name:           | inangahua river |
| RMU:                     | Local Authority |
| Displ:                   | (km)            |
| Map Reference 1:         |                 |
| Map Reference 2:         |                 |

**Structure & Materials**

|                                    |                           |
|------------------------------------|---------------------------|
| Structure Type:                    | Footbridge                |
| Cross Section Of Superstructure:   | Other                     |
| Long Section Of Superstructure:    | Suspension                |
| Deck Material:                     | Timber, Transverse Planks |
| Wearing Surface On Deck:           | Timber                    |
| Beam type:                         | Rectangular beams         |
| Beam Material:                     | Timber                    |
| Expansion Joint Type:              | None                      |
| Bearing Type:                      | Not Applicable            |
| Abutment Type:                     | Concrete, Unknown         |
| Pier Type:                         | None                      |
| Foundations:                       | Unknown                   |
| Length:                            | 50 metres                 |
| Spans (No./Length or diameter(m)): | 1/50.0                    |

**General**

|                    |         |
|--------------------|---------|
| Year Constructed:  |         |
| Design Loading:    | Unknown |
| Drawing Reference: |         |
| Local Description: |         |

**Valuation**

|   |    |
|---|----|
| Remaining Useful Life:                  | 10 |
| Replacement Cost:                       |    |
| Optimised Depreciated Replacement Cost: |    |
| Annual St Line Depreciation:            |    |

**Load Restrictions**

|                       |           |
|-----------------------|-----------|
| Max Axle Weight:      | (kg)      |
| Max Gross Weight:     | (%Class1) |
| Max Gross Weight(kg): | (kg)      |
| Speed Limit:          | (km/h)    |
| Max Height:           | metres    |

**Utilities**

|                     |     |                    |     |
|---------------------|-----|--------------------|-----|
| Water:              | N/A | Electric(O/Head):  | N/A |
| Gravity Sewer:      | N/A | Telecom(U/Ground): | N/A |
| Pressure Sewer:     | N/A | Telecom(O/Head):   | N/A |
| Stormwater:         | N/A | Streetlights:      | N/A |
| Gas:                | N/A | Fibre Optic:       | N/A |
| Electric(U/Ground): | N/A |                    |     |

**Geometrics, Safety & Footpaths**

|   |         |                                    |                         |
|---|---------|------------------------------------|-------------------------|
| No. of Lanes:                             |         | Handrail Type:                     | Steel Wire Rope barrier |
| Skew Angle:                               | degrees | Height of Handrails:               | 0.8 metres              |
| Approach Guardrails:                      | None    | Clear Width Between Handrail Tops: | 1.1 metres              |
| Kerb Or Guardrail Height:                 | metres  | Footway Width - True LHS:          | metres                  |
| Road Width Between Kerb/Guardrails:metres |         | Footway Width - True RHS:          | metres                  |



General View



Detail View



Waterway View



**STRUCTURE INVENTORY**
**Footbridge 170 Fox River Bridge**
**Location Details**

|                          |                 |
|--------------------------|-----------------|
| RAMM / Alt. Database ID: |                 |
| Road Name:               | SH6             |
| Waterway Name:           | Fox River       |
| RMU:                     | Local Authority |
| Displ:                   | (km)            |
| Map Reference 1:         |                 |
| Map Reference 2:         |                 |

**Structure & Materials**

|                                    |                           |
|------------------------------------|---------------------------|
| Structure Type:                    | Footbridge                |
| Cross Section Of Superstructure:   | Timber single span        |
| Long Section Of Superstructure:    | Simple Spans              |
| Deck Material:                     | Timber, Transverse Planks |
| Wearing Surface On Deck:           | Timber                    |
| Beam type:                         | Rectangular beams         |
| Beam Material:                     | Timber                    |
| Expansion Joint Type:              | Air Gap                   |
| Bearing Type:                      | Timber                    |
| Abutment Type:                     | Timber                    |
| Pier Type:                         | Timber                    |
| Foundations:                       | Driven piles, timber      |
| Length:                            | metres                    |
| Spans (No./Length or diameter(m)): |                           |

**General**

|                    |                  |
|--------------------|------------------|
| Year Constructed:  | 1929             |
| Design Loading:    | Unknown          |
| Drawing Reference: |                  |
| Local Description: | Fox River Bridge |

**Valuation**

|   |   |
|---|---|
| Remaining Useful Life:                  | 0 |
| Replacement Cost:                       |   |
| Optimised Depreciated Replacement Cost: |   |
| Annual St Line Depreciation:            |   |

**Load Restrictions**

|                       |           |
|-----------------------|-----------|
| Max Axle Weight:      | (kg)      |
| Max Gross Weight:     | (%Class1) |
| Max Gross Weight(kg): | (kg)      |
| Speed Limit:          | (km/h)    |
| Max Height:           | metres    |

**Utilities**

|                     |     |                    |     |
|---------------------|-----|--------------------|-----|
| Water:              | N/A | Electric(O/Head):  | N/A |
| Gravity Sewer:      | N/A | Telecom(U/Ground): | N/A |
| Pressure Sewer:     | N/A | Telecom(O/Head):   | N/A |
| Stormwater:         | N/A | Streetlights:      | N/A |
| Gas:                | N/A | Fibre Optic:       | N/A |
| Electric(U/Ground): | N/A |                    |     |

**Geometrics, Safety & Footpaths**

|   |         |                                    |                       |
|---|---------|------------------------------------|-----------------------|
| No. of Lanes:                             | 1       | Handrail Type:                     | Timber Post with Wire |
| Skew Angle:                               | degrees | Height of Handrails:               | metres                |
| Approach Guardrails:                      | None    | Clear Width Between Handrail Tops: | metres                |
| Kerb Or Guardrail Height:                 | metres  | Footway Width - True LHS:          | metres                |
| Road Width Between Kerb/Guardrails:metres |         | Footway Width - True RHS:          | metres                |



**NO IMAGE FOUND**

General View



**NO IMAGE FOUND**

Detail View



**NO IMAGE FOUND**

Waterway View

**Location Details**

|                          |                     |
|--------------------------|---------------------|
| RAMM / Alt. Database ID: |                     |
| Road Name:               | BEACH RD (FAIRDOWN) |
| Waterway Name:           |                     |
| RMU:                     | Local Authority     |
| Displ:                   | (km)                |
| Map Reference 1:         | 2381024 5922795     |
| Map Reference 2:         |                     |

**Structure & Materials**

|                                    |                         |
|------------------------------------|-------------------------|
| Structure Type:                    | Footbridge              |
| Cross Section Of Superstructure:   | Slab                    |
| Long Section Of Superstructure:    | Monolithic with support |
| Deck Material:                     | Concrete, Unknown       |
| Wearing Surface On Deck:           | Concrete                |
| Beam type:                         | Unknown                 |
| Beam Material:                     | Concrete, Unknown       |
| Expansion Joint Type:              | None                    |
| Bearing Type:                      | Not Applicable          |
| Abutment Type:                     | Formed by foundations   |
| Pier Type:                         | None                    |
| Foundations:                       | Spread footing          |
| Length:                            | metres                  |
| Spans (No./Length or diameter(m)): |                         |

**General**

|                    |                          |
|--------------------|--------------------------|
| Year Constructed:  |                          |
| Design Loading:    |                          |
| Drawing Reference: |                          |
| Local Description: | HAMPTONS ROCK CHARLESTON |

**Valuation**

|   |   |
|---|---|
| Remaining Useful Life:                  | 5 |
| Replacement Cost:                       |   |
| Optimised Depreciated Replacement Cost: |   |
| Annual St Line Depreciation:            |   |

**Load Restrictions**

|                       |           |
|-----------------------|-----------|
| Max Axle Weight:      | (kg)      |
| Max Gross Weight:     | (%Class1) |
| Max Gross Weight(kg): | (kg)      |
| Speed Limit:          | (km/h)    |
| Max Height:           | metres    |

**Utilities**

|                     |     |                    |     |
|---------------------|-----|--------------------|-----|
| Water:              | N/A | Electric(O/Head):  | N/A |
| Gravity Sewer:      | N/A | Telecom(U/Ground): | N/A |
| Pressure Sewer:     | N/A | Telecom(O/Head):   | N/A |
| Stormwater:         | N/A | Streetlights:      | N/A |
| Gas:                | N/A | Fibre Optic:       | N/A |
| Electric(U/Ground): | N/A |                    |     |

**Geometrics, Safety & Footpaths**

|   |         |                           |                         |
|---|---------|---------------------------|-------------------------|
| No. of Lanes:                             |         | Handrail Type:            | Steel Wire Rope barrier |
| Skew Angle:                               | degrees | Height of Handrails:      | metres                  |
| Approach Guardrails:                      | None    | Clear Width Between       | 0.6 metres              |
| Kerb Or Guardrail Height:                 | metres  | Handrail Tops:            |                         |
| Road Width Between Kerb/Guardrails:metres |         | Footway Width - True LHS: | metres                  |
|   |         | Footway Width - True RHS: | metres                  |



General View



Detail View



Waterway View



**Footbridge 177 MOKIHINUI PEDESTRIAN BRIDGE**
**Location Details**

|                          |                 |
|--------------------------|-----------------|
| RAMM / Alt. Database ID: |                 |
| Road Name:               | MOKIHINUI ROAD  |
| Waterway Name:           | Burkes creek    |
| RMU:                     | Local Authority |
| Displ:                   | (km)            |
| Map Reference 1:         |                 |
| Map Reference 2:         |                 |

**Structure & Materials**

|                                    |                           |
|------------------------------------|---------------------------|
| Structure Type:                    | Footbridge                |
| Cross Section Of Superstructure:   | Timber single span        |
| Long Section Of Superstructure:    | Simple Spans              |
| Deck Material:                     | Timber, Transverse Planks |
| Wearing Surface On Deck:           | Timber Deck Planks        |
| Beam type:                         | Rectangular beams         |
| Beam Material:                     | Timber                    |
| Expansion Joint Type:              | None                      |
| Bearing Type:                      | Not Applicable            |
| Abutment Type:                     | Timber                    |
| Pier Type:                         | Timber                    |
| Foundations:                       | Driven piles, timber      |
| Length:                            | metres                    |
| Spans (No./Length or diameter(m)): | 1/13.1                    |

**General**

|                    |       |
|--------------------|-------|
| Year Constructed:  |       |
| Design Loading:    | Other |
| Drawing Reference: |       |
| Local Description: |       |

**Valuation**

|   |    |
|---|----|
| Remaining Useful Life:                  | 15 |
| Replacement Cost:                       |    |
| Optimised Depreciated Replacement Cost: |    |
| Annual St Line Depreciation:            |    |

**Load Restrictions**


|                       |           |
|-----------------------|-----------|
| Max Axle Weight:      | (kg)      |
| Max Gross Weight:     | (%Class1) |
| Max Gross Weight(kg): | (kg)      |
| Speed Limit:          | (km/h)    |
| Max Height:           | metres    |

**Utilities**


|                     |     |                    |     |
|---------------------|-----|--------------------|-----|
| Water:              | N/A | Electric(O/Head):  | N/A |
| Gravity Sewer:      | N/A | Telecom(U/Ground): | N/A |
| Pressure Sewer:     | N/A | Telecom(O/Head):   | N/A |
| Stormwater:         | N/A | Streetlights:      | N/A |
| Gas:                | N/A | Fibre Optic:       | N/A |
| Electric(U/Ground): | N/A |                    |     |

**Geometrics, Safety & Footpaths**

|   |         |                                    |                      |
|---|---------|------------------------------------|----------------------|
| No. of Lanes:                             |         | Handrail Type:                     | Timber Post and Rail |
| Skew Angle:                               | degrees | Height of Handrails:               | 0.9 metres           |
| Approach Guardrails:                      | None    | Clear Width Between Handrail Tops: | 0.6 metres           |
| Kerb Or Guardrail Height:                 | metres  | Footway Width - True LHS:          | metres               |
| Road Width Between Kerb/Guardrails:metres |         | Footway Width - True RHS:          | metres               |

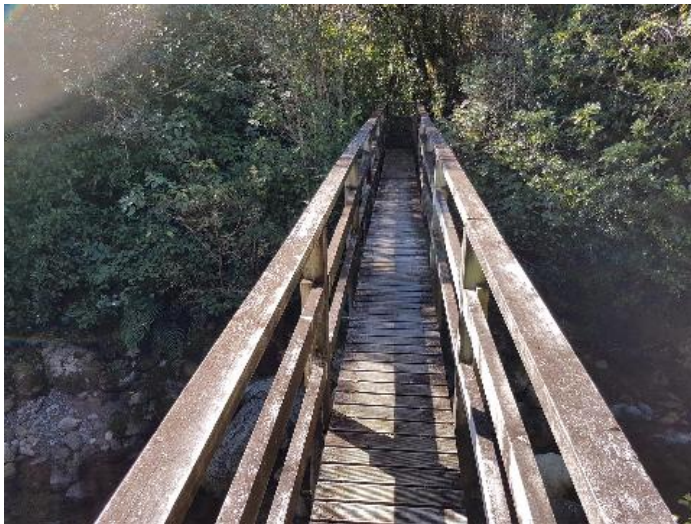

General View

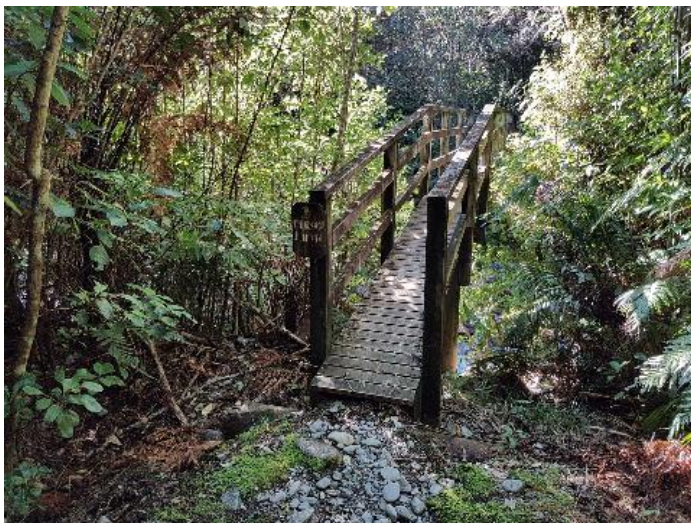

Detail View



Waterway View



**Footbridge 1000 REEFTON SUSPENSION BRIDGE**
**Location Details**

|                          |                 |
|--------------------------|-----------------|
| RAMM / Alt. Database ID: |                 |
| Road Name:               | SH6             |
| Waterway Name:           | inangahua river |
| RMU:                     | Local Authority |
| Displ:                   | (km)            |
| Map Reference 1:         |                 |
| Map Reference 2:         |                 |

**Structure & Materials**

|                                    |                           |
|------------------------------------|---------------------------|
| Structure Type:                    | Footbridge                |
| Cross Section Of Superstructure:   | Other                     |
| Long Section Of Superstructure:    | Suspension                |
| Deck Material:                     | Timber, Transverse Planks |
| Wearing Surface On Deck:           | Timber                    |
| Beam type:                         | Rectangular beams         |
| Beam Material:                     | Timber                    |
| Expansion Joint Type:              | None                      |
| Bearing Type:                      | Not Applicable            |
| Abutment Type:                     | Concrete, Unknown         |
| Pier Type:                         | Concrete, Unknown         |
| Foundations:                       | Unknown                   |
| Length:                            | 46 metres                 |
| Spans (No./Length or diameter(m)): | 1/46.0                    |

**General**

|                    |                                    |
|--------------------|------------------------------------|
| Year Constructed:  |                                    |
| Design Loading:    | Unknown                            |
| Drawing Reference: |                                    |
| Local Description: | Power House Walk Suspension Bridge |

**Valuation**

|   |   |
|---|---|
| Remaining Useful Life:                  | 5 |
| Replacement Cost:                       |   |
| Optimised Depreciated Replacement Cost: |   |
| Annual St Line Depreciation:            |   |

**Load Restrictions**

|                       |           |
|-----------------------|-----------|
| Max Axle Weight:      | (kg)      |
| Max Gross Weight:     | (%Class1) |
| Max Gross Weight(kg): | (kg)      |
| Speed Limit:          | (km/h)    |
| Max Height:           | metres    |

**Utilities**

|                     |     |                    |     |
|---------------------|-----|--------------------|-----|
| Water:              | N/A | Electric(O/Head):  | N/A |
| Gravity Sewer:      | N/A | Telecom(U/Ground): | N/A |
| Pressure Sewer:     | N/A | Telecom(O/Head):   | N/A |
| Stormwater:         | N/A | Streetlights:      | N/A |
| Gas:                | N/A | Fibre Optic:       | N/A |
| Electric(U/Ground): | N/A |                    |     |

**Geometrics, Safety & Footpaths**

|   |         |                              |            |
|---|---------|------------------------------|------------|
| No. of Lanes:                             |         | Handrail Type:               | Other      |
| Skew Angle:                               | degrees | Height of Handrails:         | 1 metres   |
| Approach Guardrails:                      | None    | Clear Width Between Handrail | 0.9 metres |
| Kerb Or Guardrail Height:                 | metres  | Tops:                        |            |
| Road Width Between Kerb/Guardrails:metres |         | Footway Width - True LHS:    | metres     |
|   |         | Footway Width - True RHS:    | metres     |



**NO IMAGE  
FOUND**

General View



Detail View



Waterway View